



MAP OF THE KJÖLI MINE IN NORWAY.

SCALE 1:500.

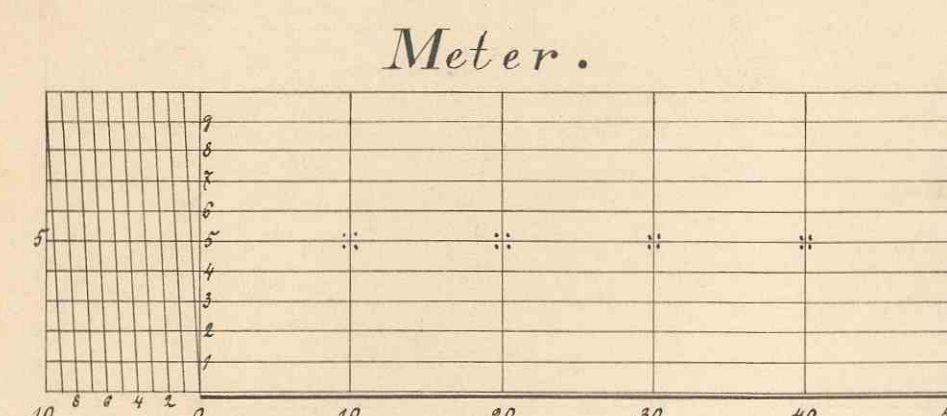

Key:

- The red lines mark the S. part of the mine
 " yellow " " " NW. " " "
 " blue " " " NE. " " "
 " red figures " " width of the ore
 " blue " " " numb. " " levels
 " black "[1-475]" " surveying stations
 " Declination is 11.5° W.

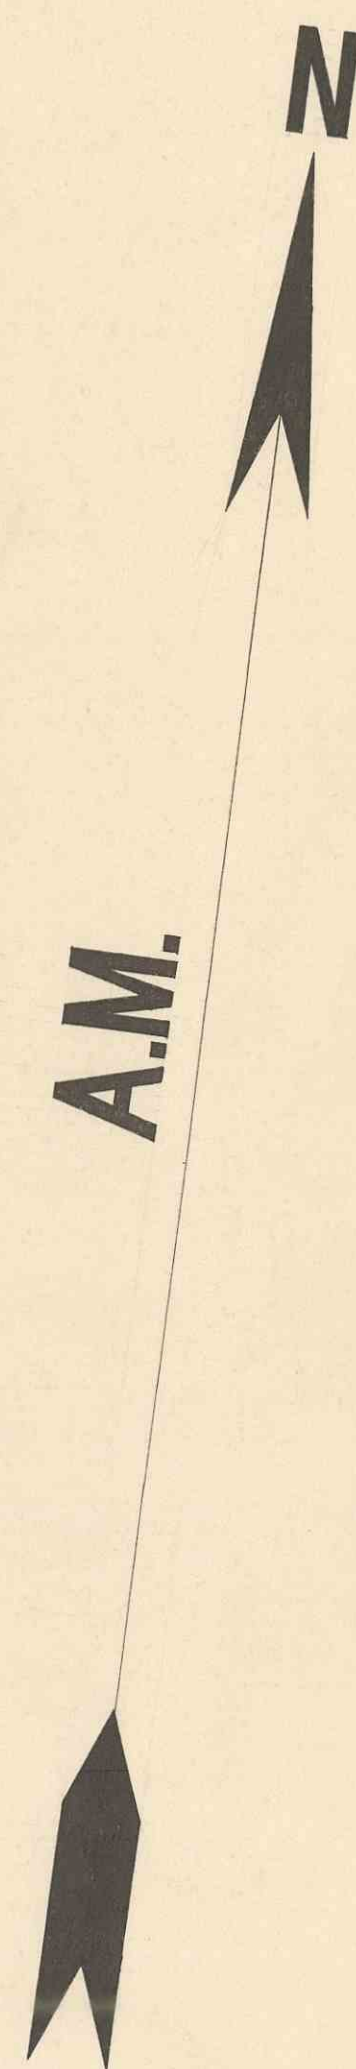


PLAN.




VERTICAL

SECTION.

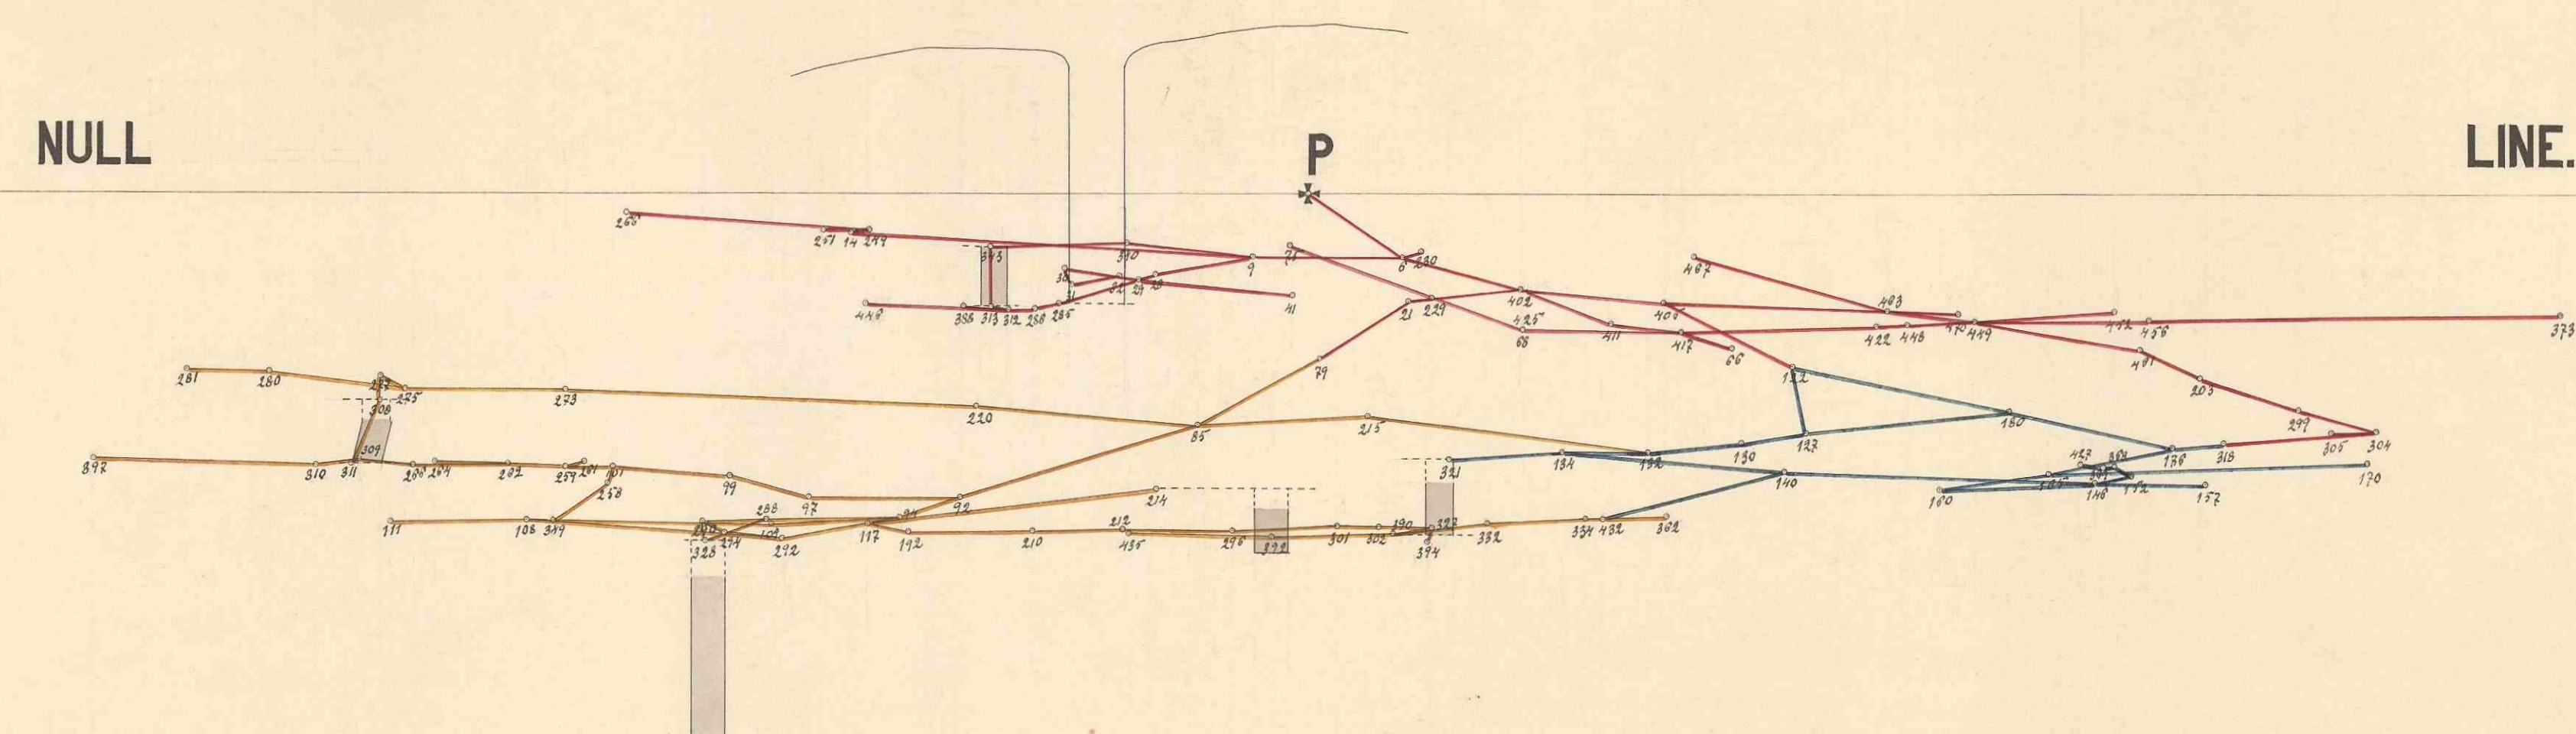

TRANSVERSE
SECTION.

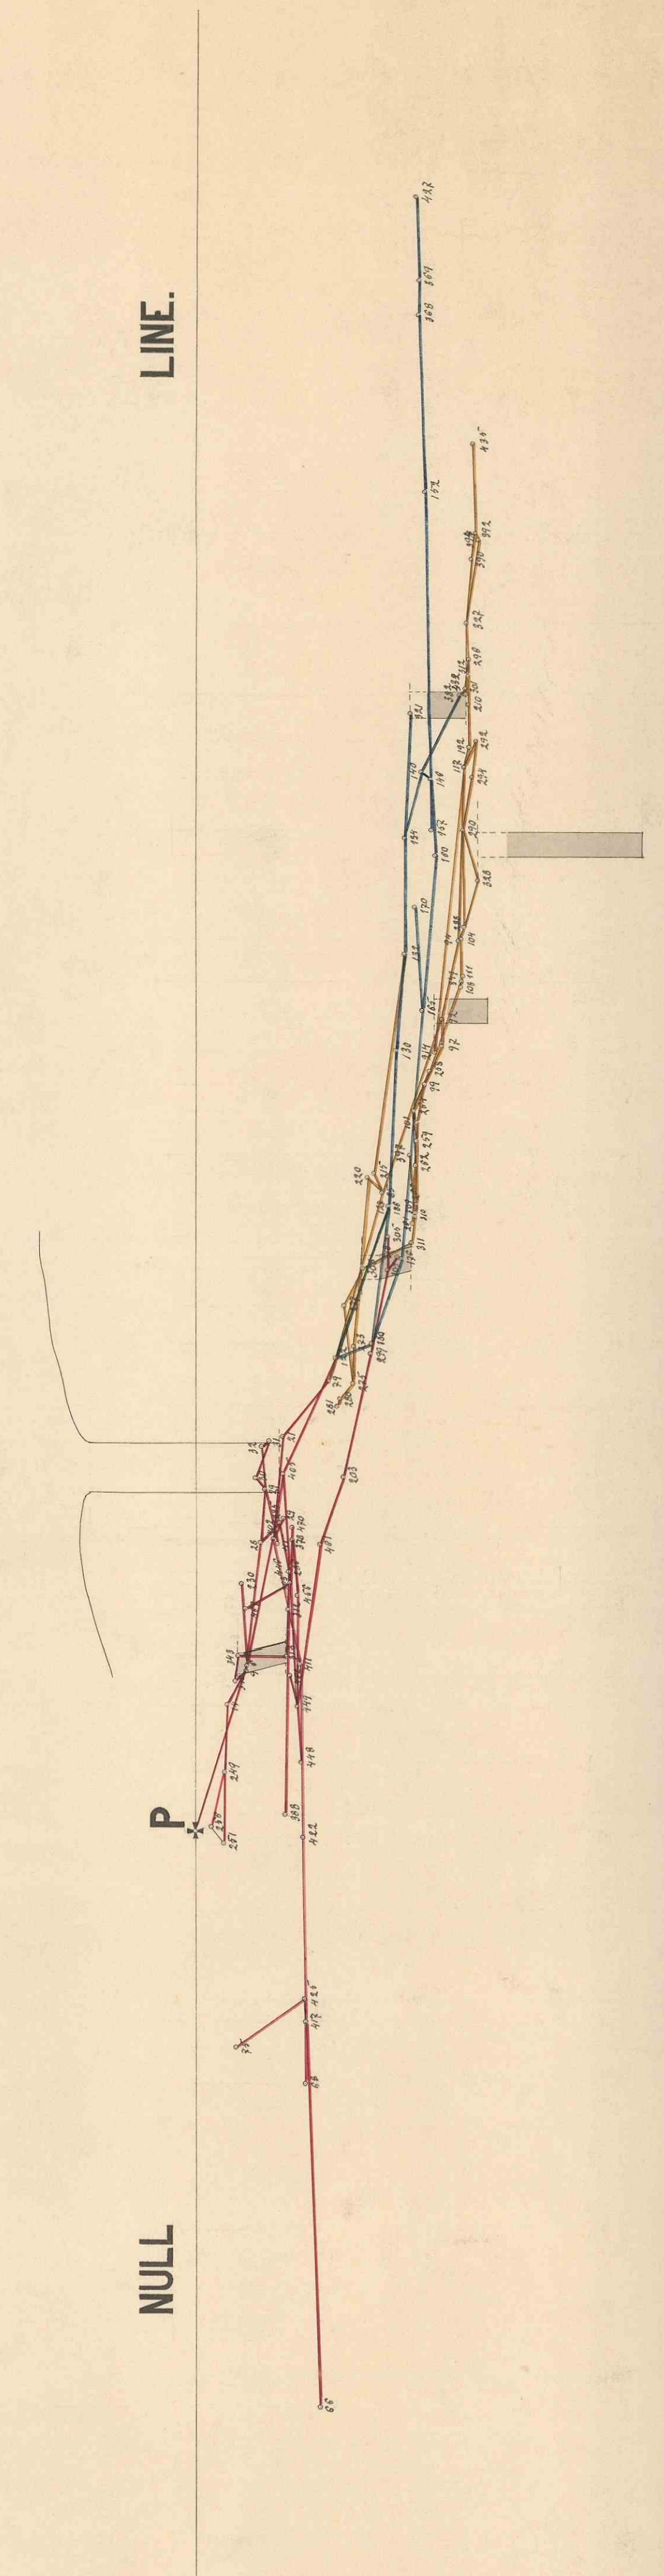

LINE.